




insight
design

2930 N.E.
2ND COURT
Miami
Florida
3 3 1 3 7
305 545 4964

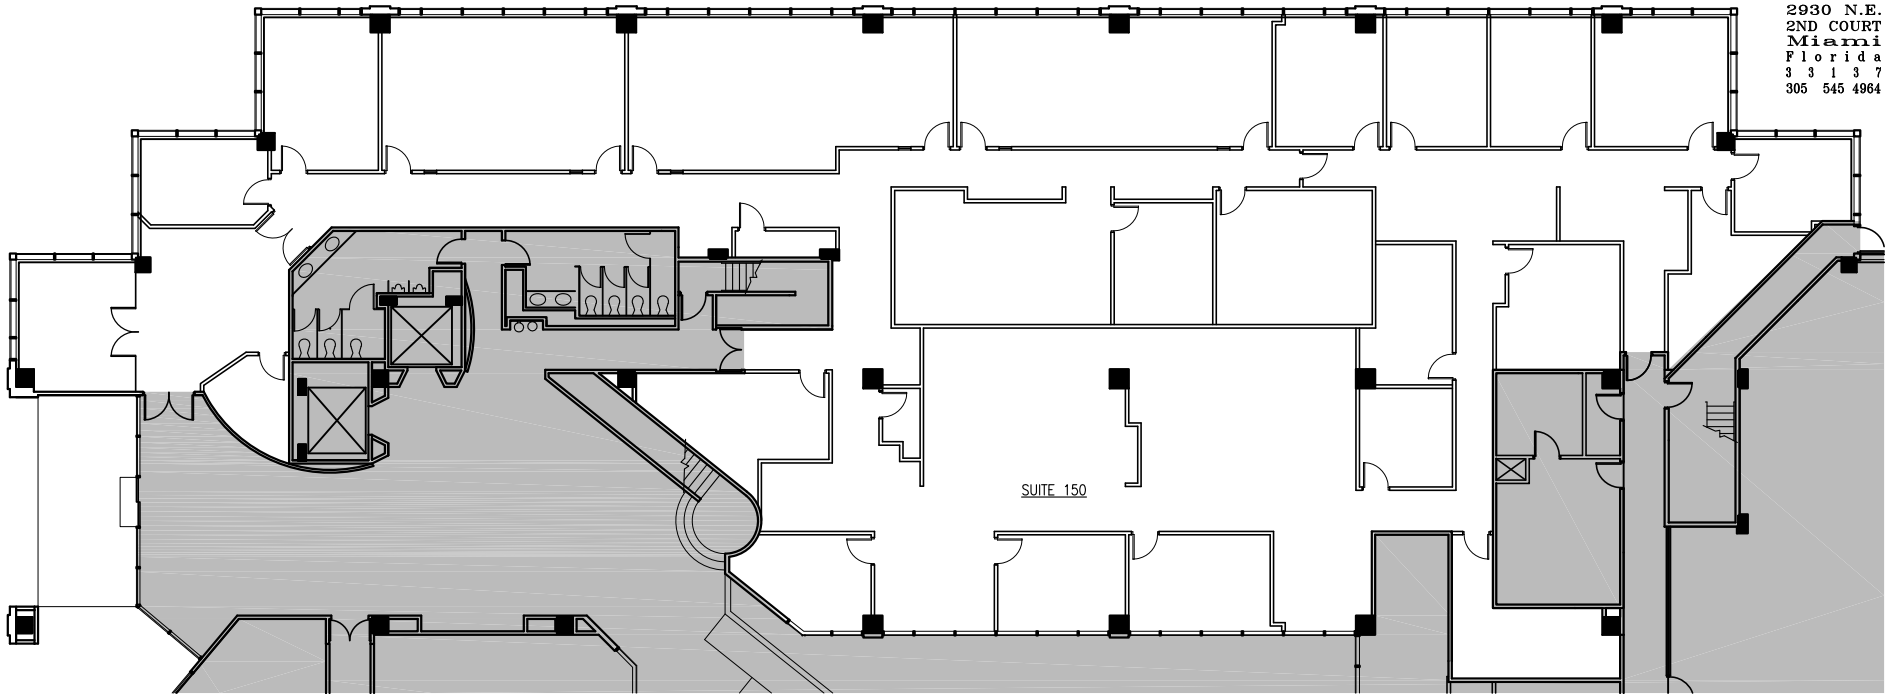

SUITE 150

Management & Leasing by
TAYLOR&MATHIS

6100 WATERFORD AT BLUE LAGOON

June 30th, 2011

AS-BUILT

SUITE 150
N.T.S.

