




insight
design

1955 Northwest
17th Avenue
Miami
Florida
33125
305 545 4964

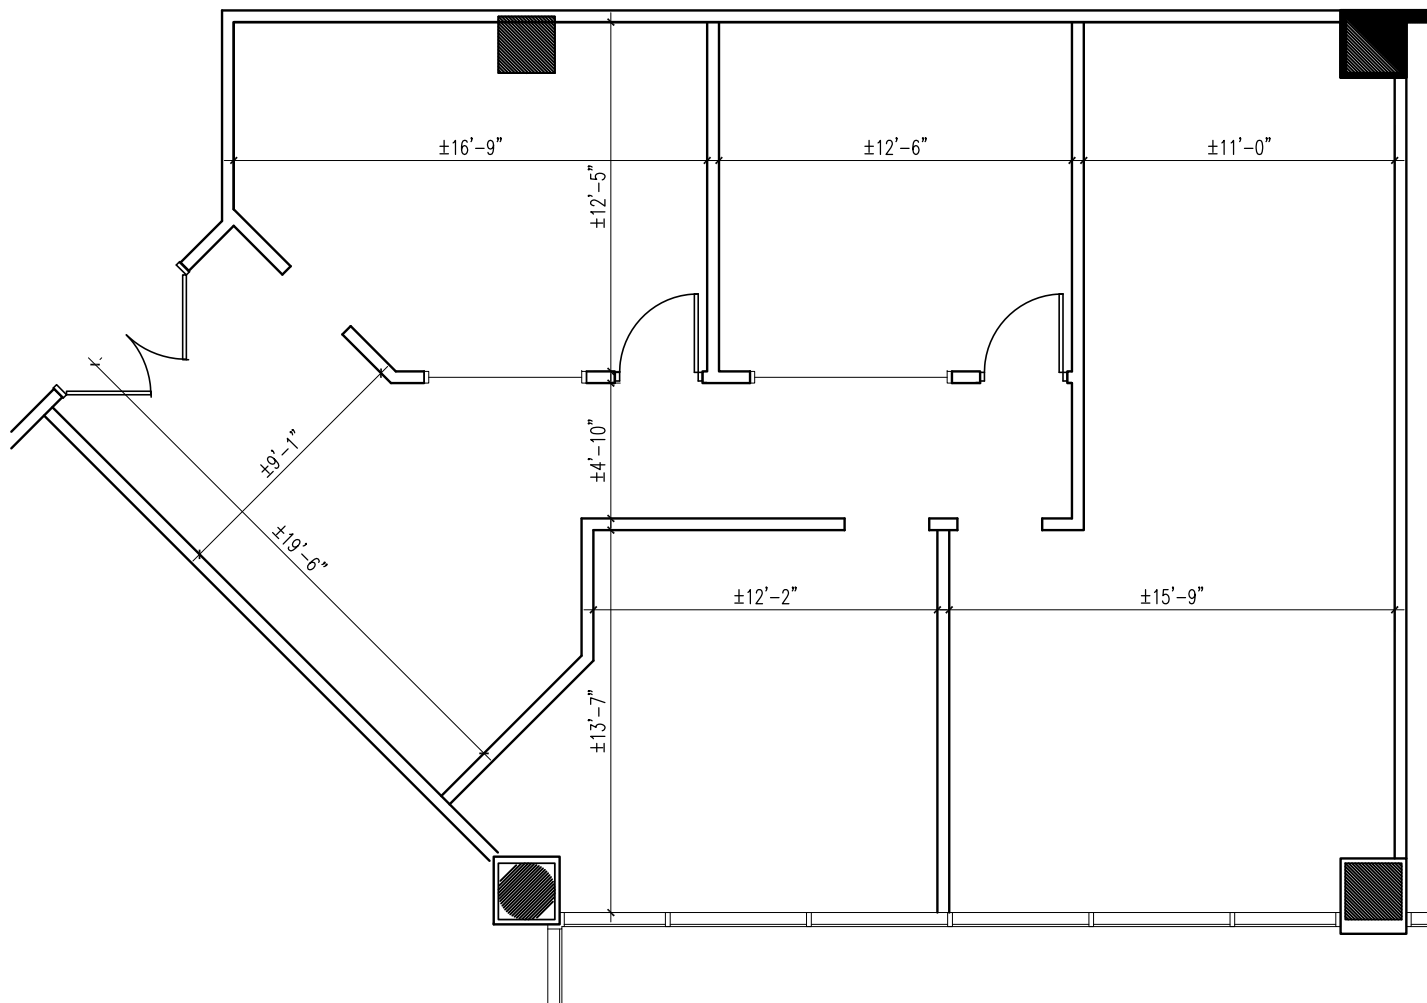

Management & Leasing by
TAYLOR&MATHIS

6100 Blue Lagoon Dr.

February 7th, 2011

As-Built Plan

Suite 355

N.T.S.

