




insight
design

1955 Northwest
17th Avenue
Miami
Florida
33125
305 545 4964

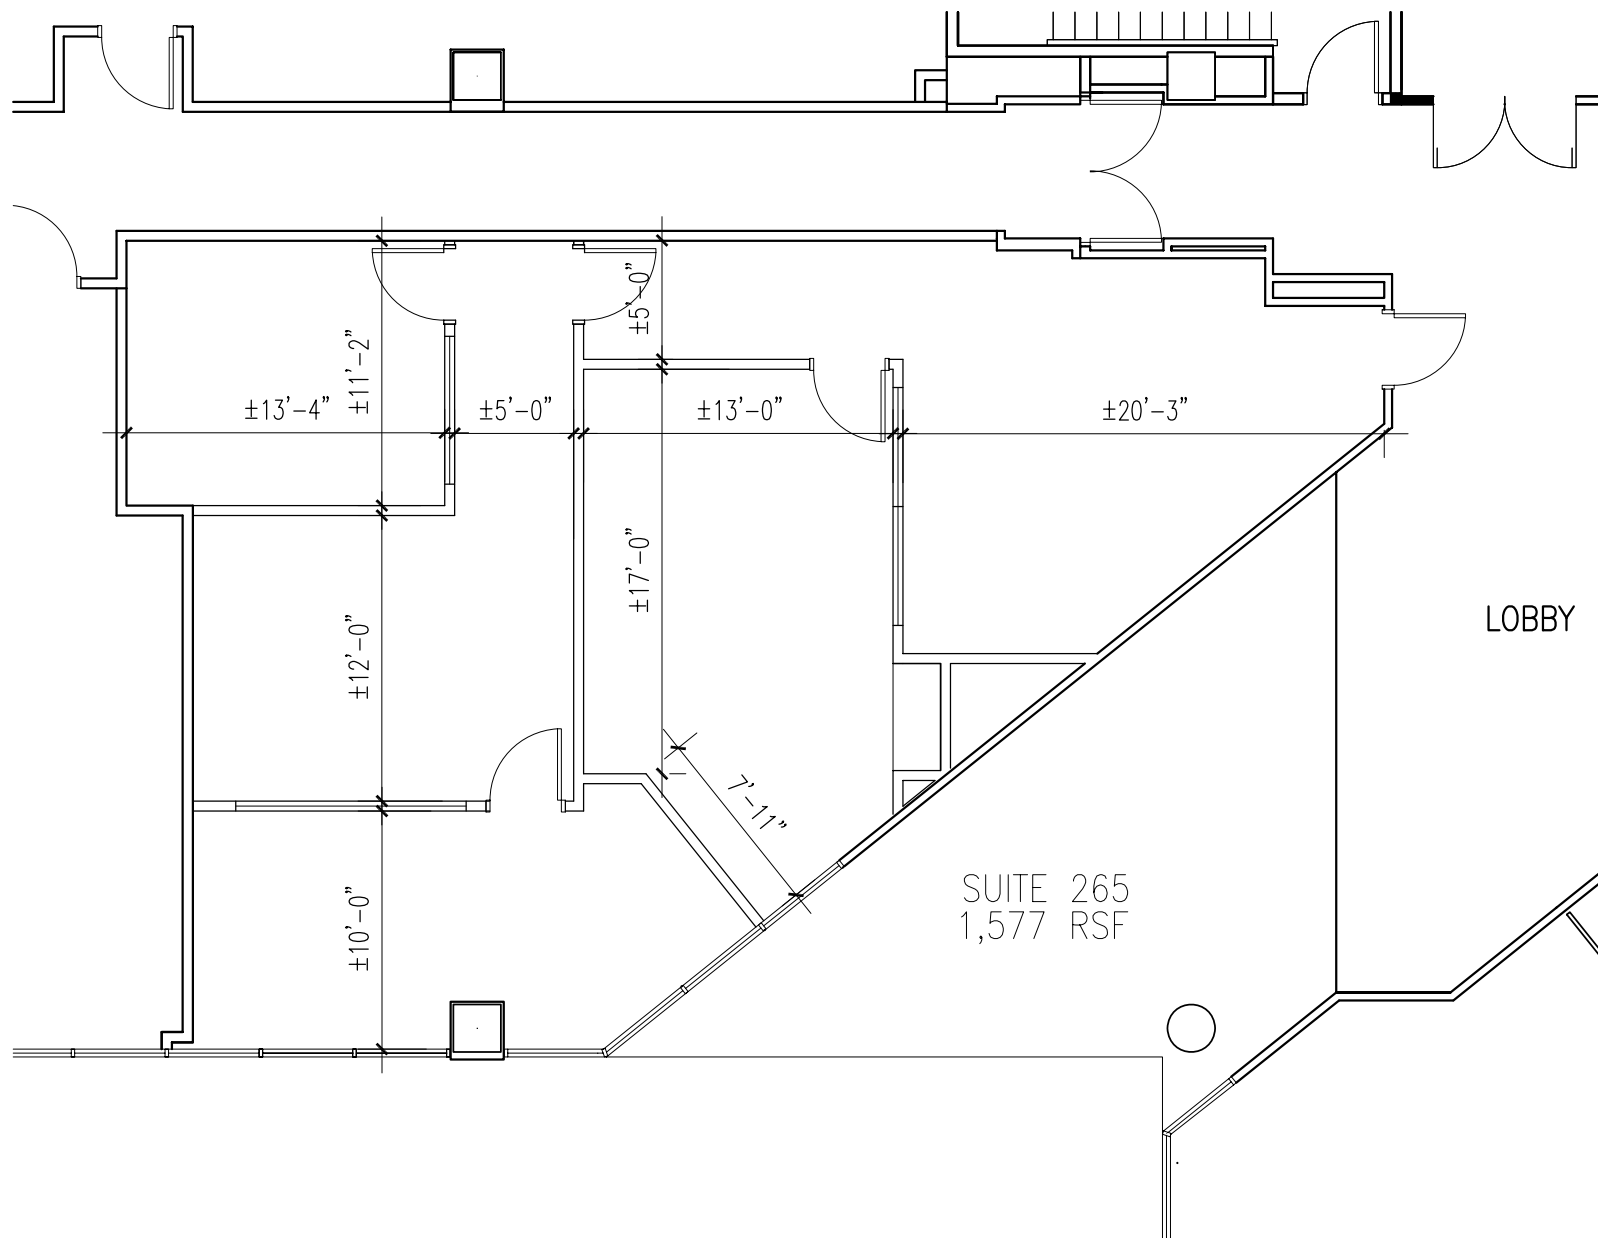

6303 Blue Lagoon Dr.

02.28.07

As-Built

Suite 265
NTS