




insight
design

1955 Northwest
17th Avenue
Miami
Florida
3 3 1 2 5
305 545 4964

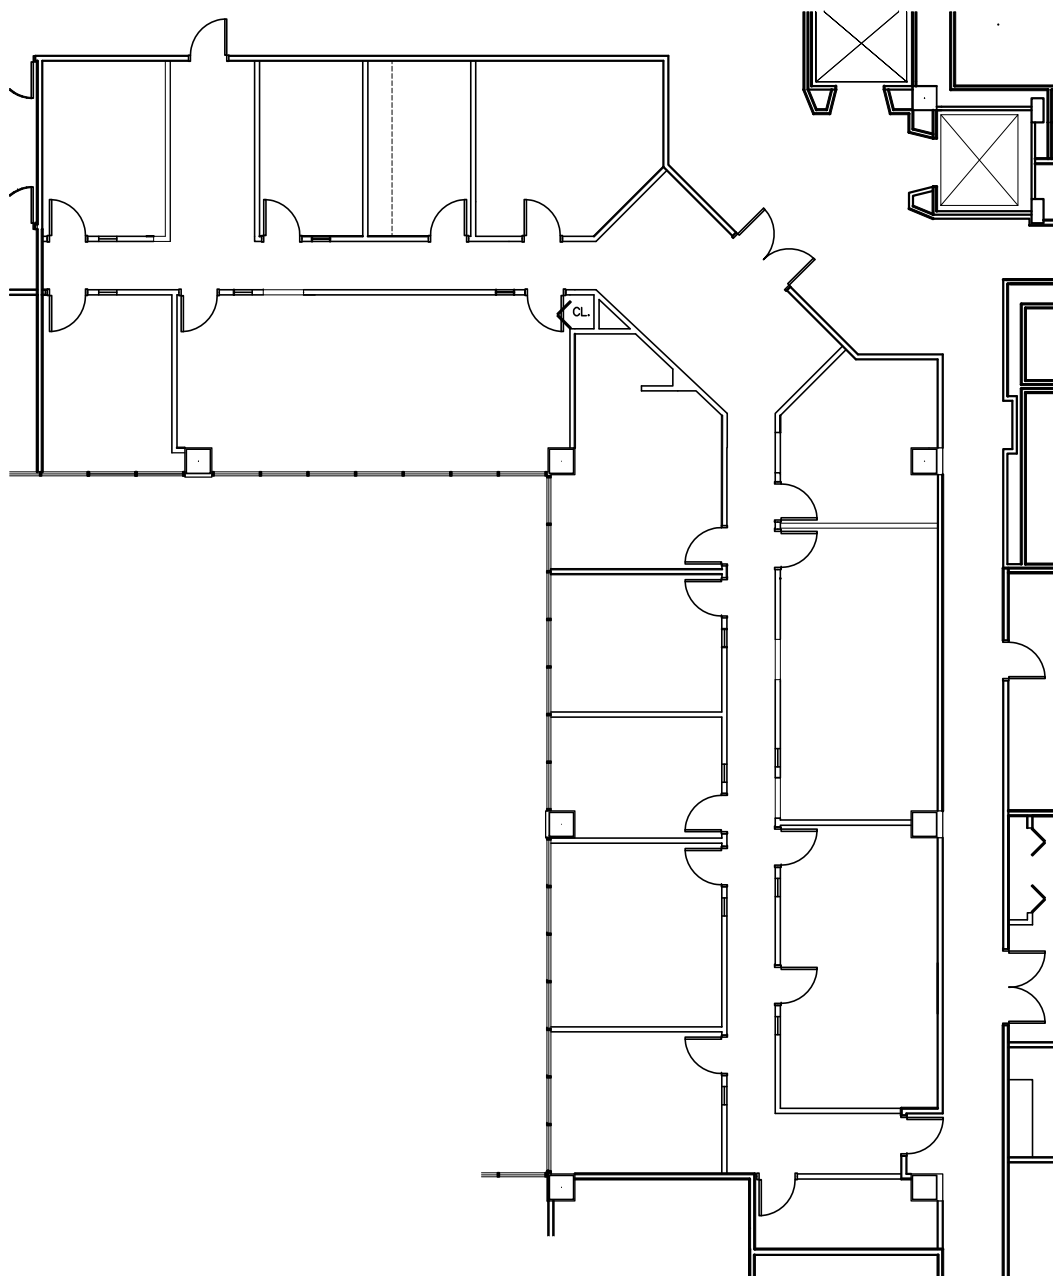

Management & Leasing by
TAYLOR&MATHIS

6303 WATERFORD AT BLUE LAGOON

January 13th, 2011

AS-BUILT

SUITE 375

N.T.S.

