




1955 Northwest
17th Avenue
Miami
Florida
3 3 1 2 5
305 545 4964

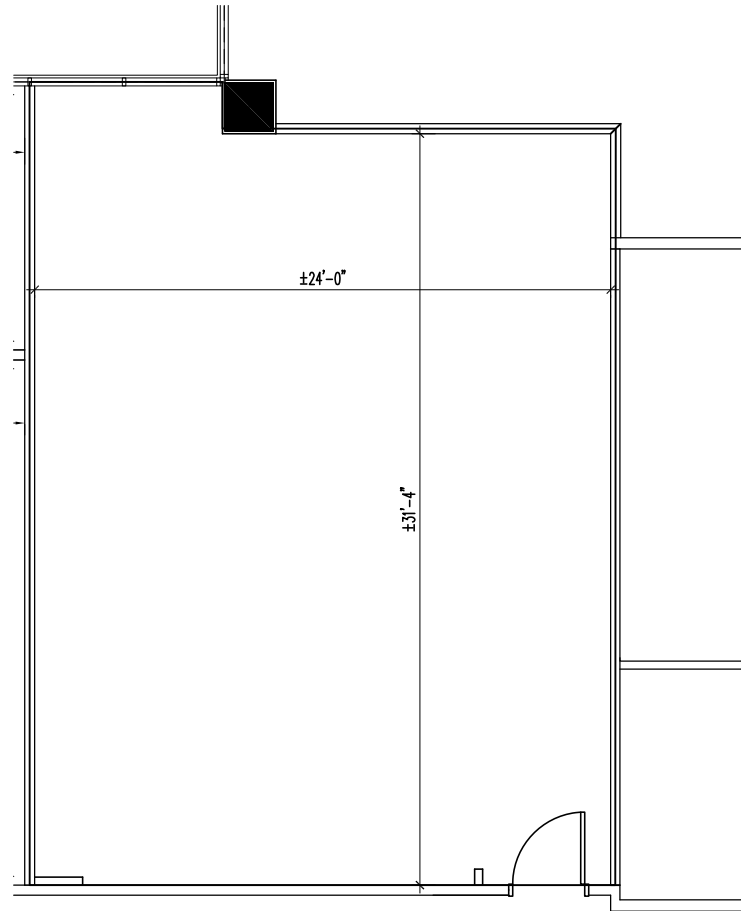

Management & Leasing by
TAYLOR&MATHIS

6505 Blue Lagoon Dr.

October 16th, 2009

AS-BUILT

SUITE 425
N.T.S.

