




insight  
design

2930 Northeast  
2nd Court  
Miami  
Florida  
3 3 1 3 7  
305 545 4964

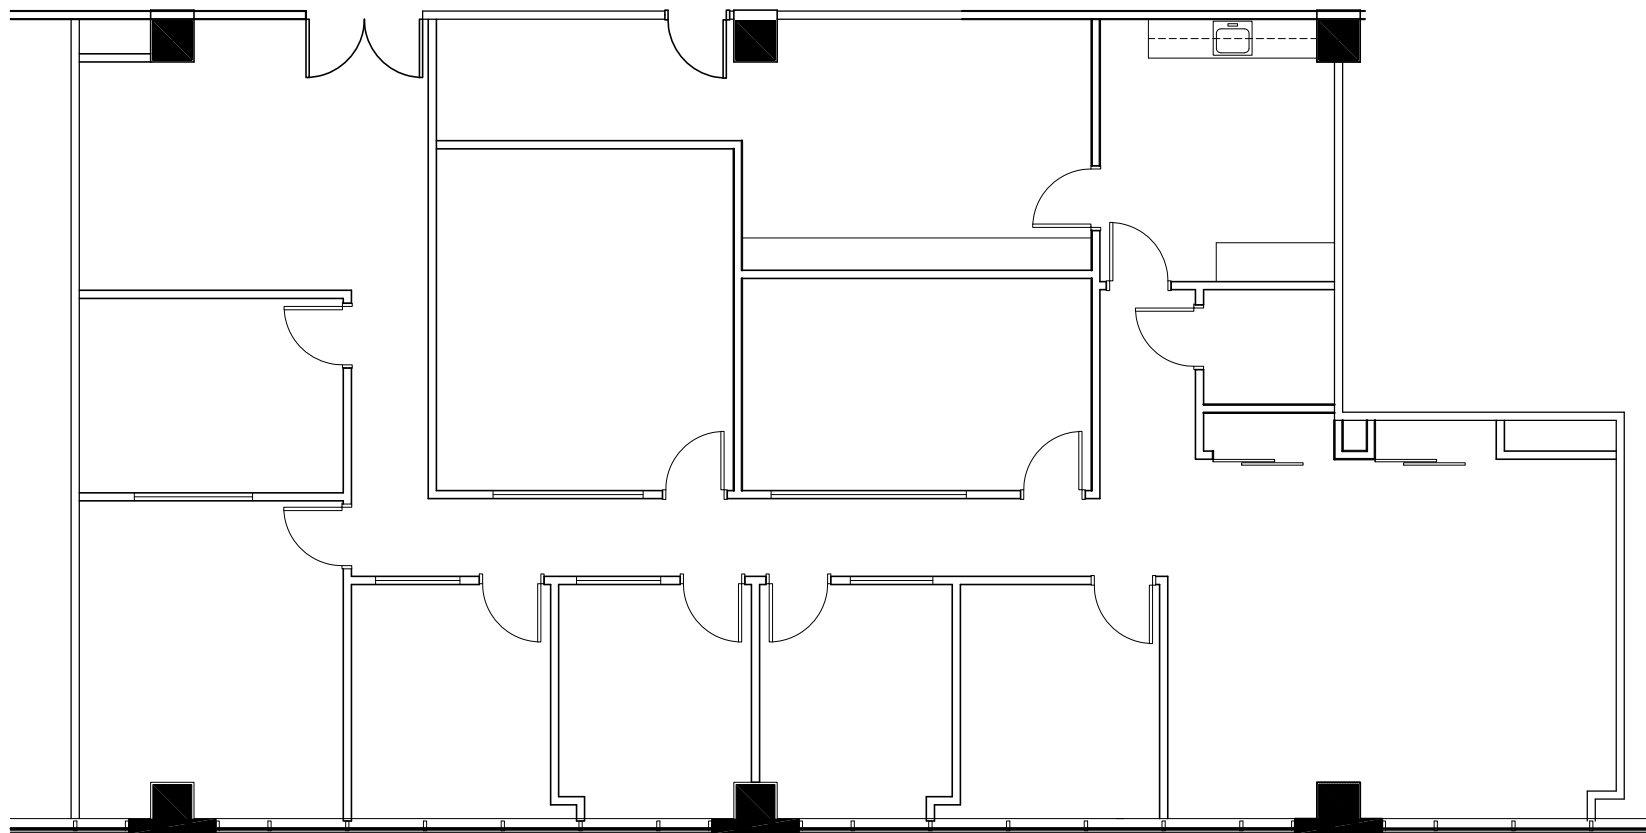

# 6505 WATERFORD AT BLUE LAGOON

October 15th, 2012

AS-BUILT

SUITE 430  
N.T.S.



Leasing by

TAYLOR&MATHIS