


SUITE 470

TAMPA DISTRIBUTION CENTER -

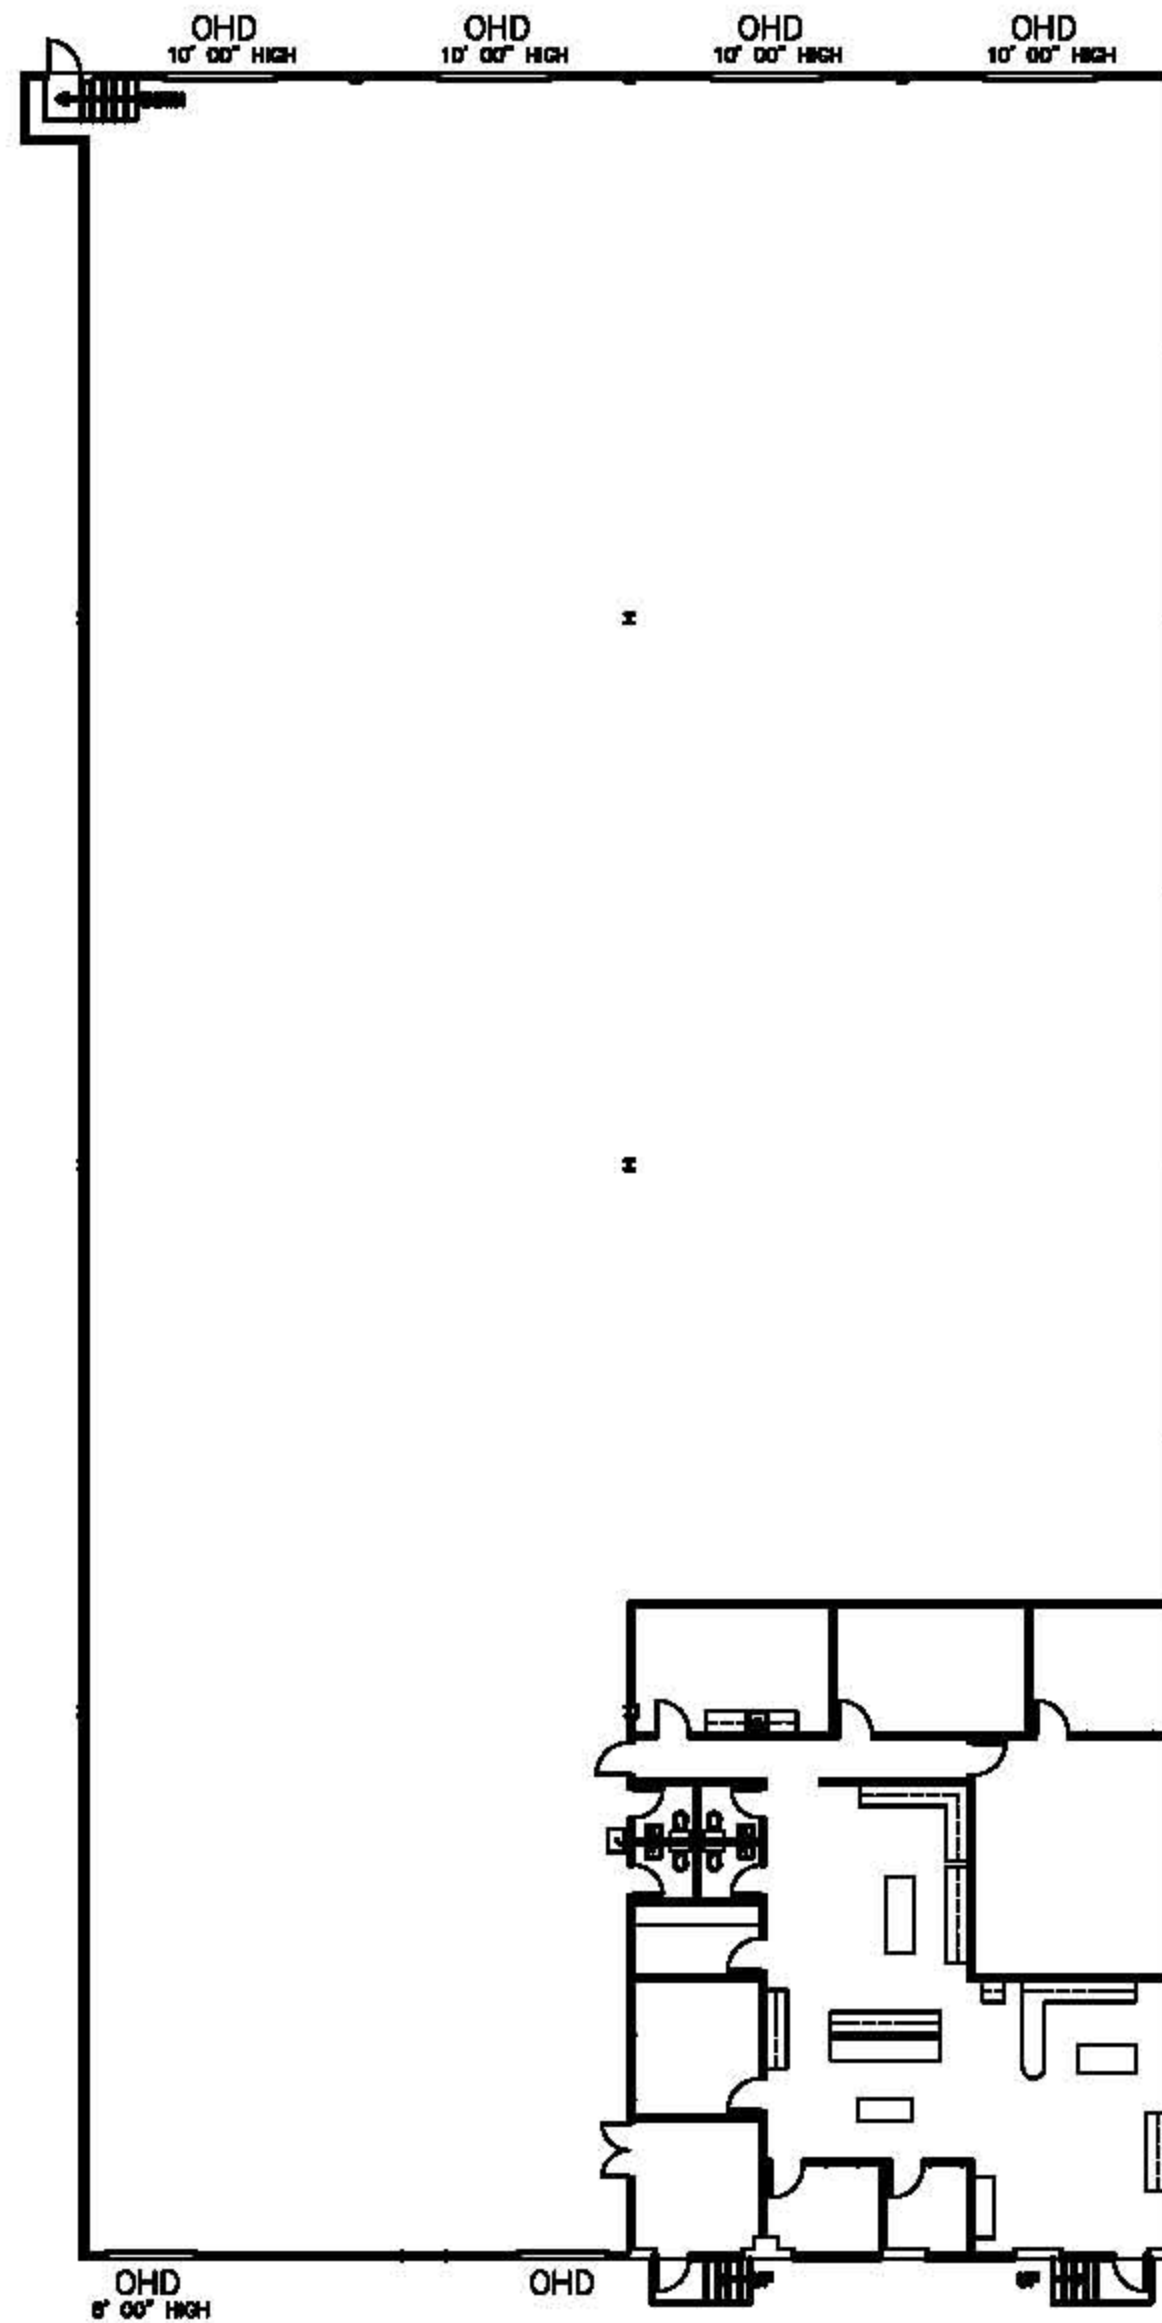


WAREHOUSE AS-BUILT

SCALE: NTS

11-11-10

OFFICE 2,941 RSF

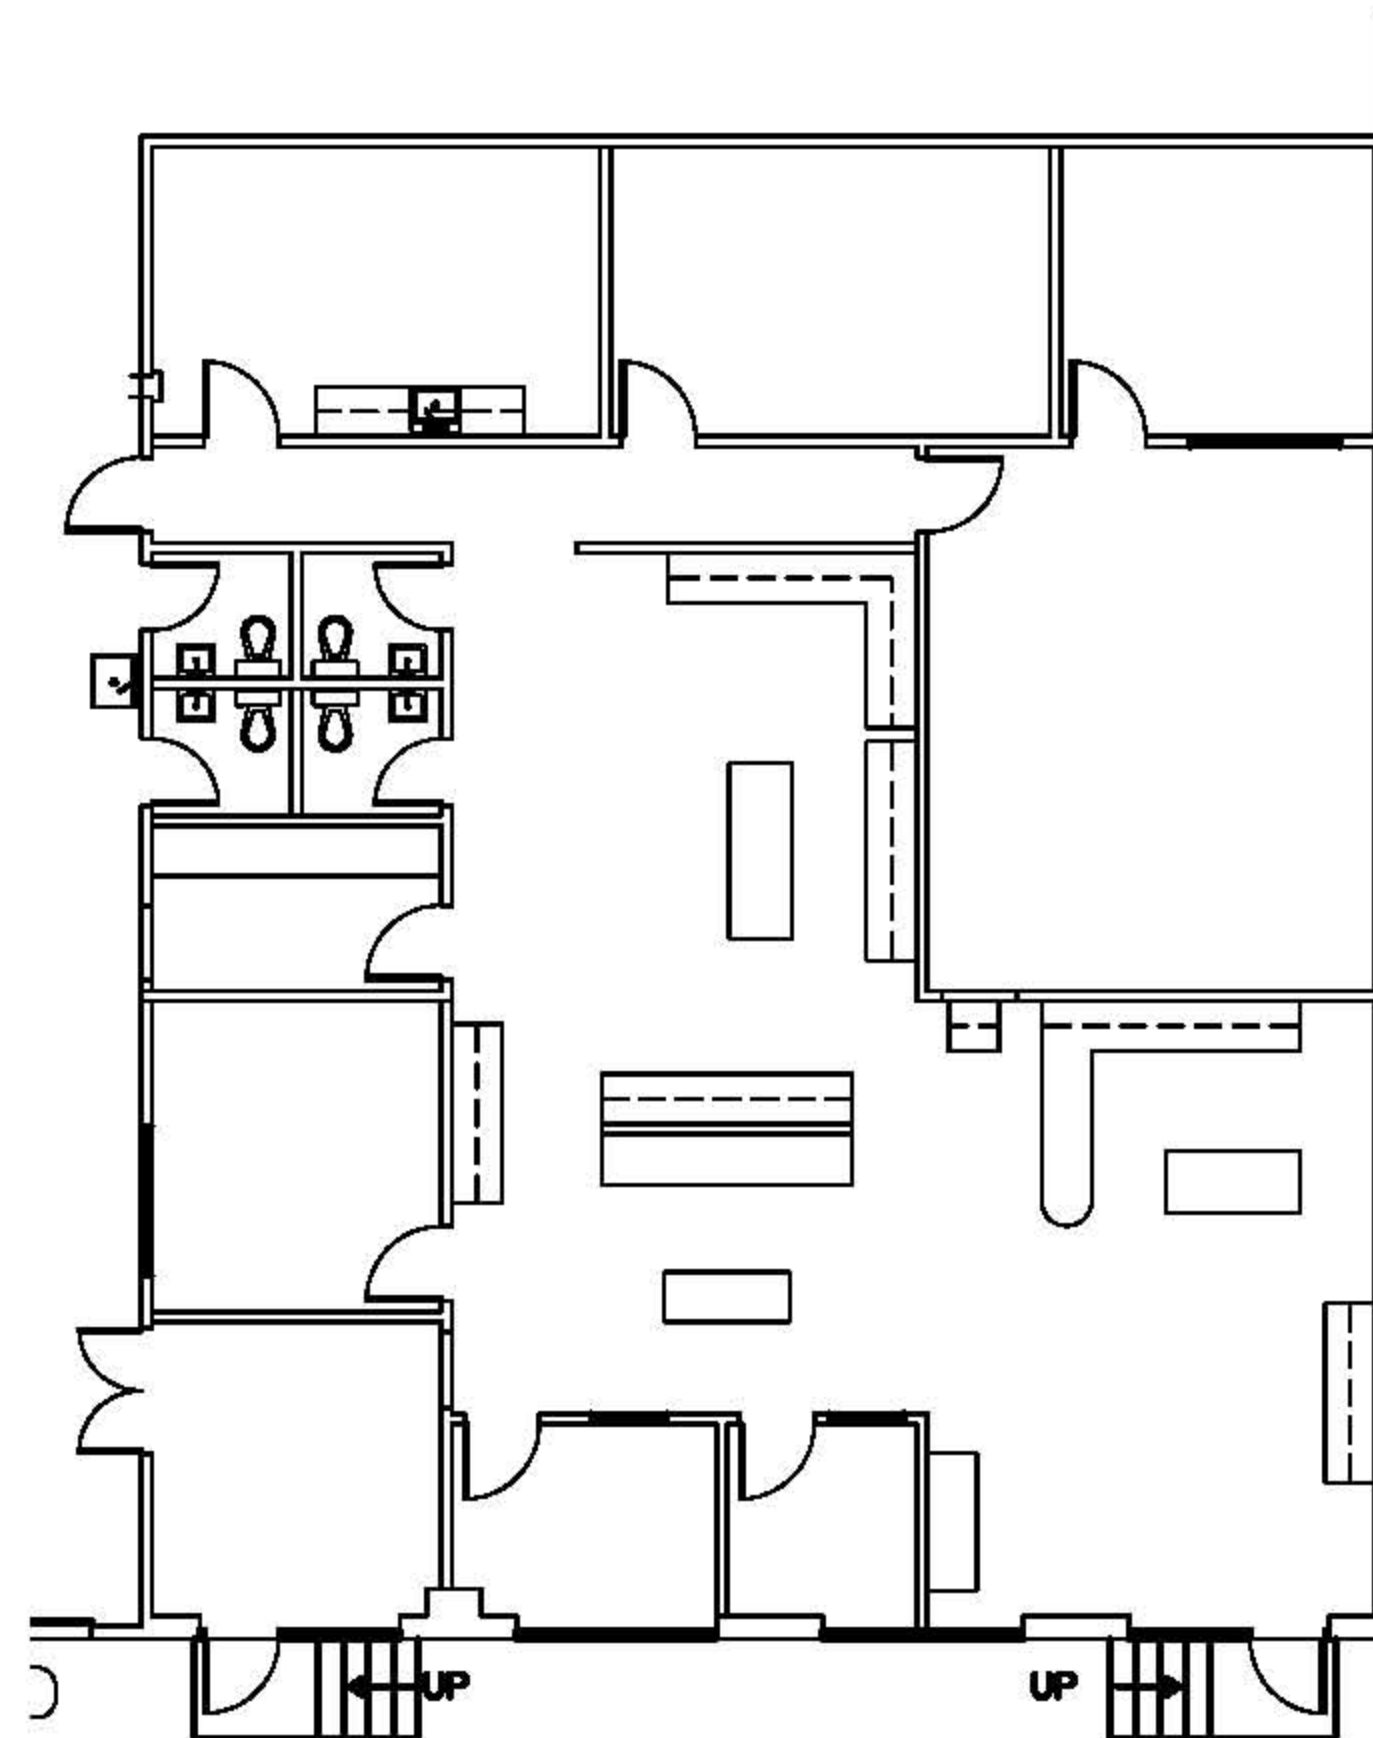

OFFICE AS-BUILT

SCALE: 1/16" = 1'-0"

11-11-10