




insight
design

1955 Northwest
17th Avenue
Miami
Florida
33125
305 545 4964

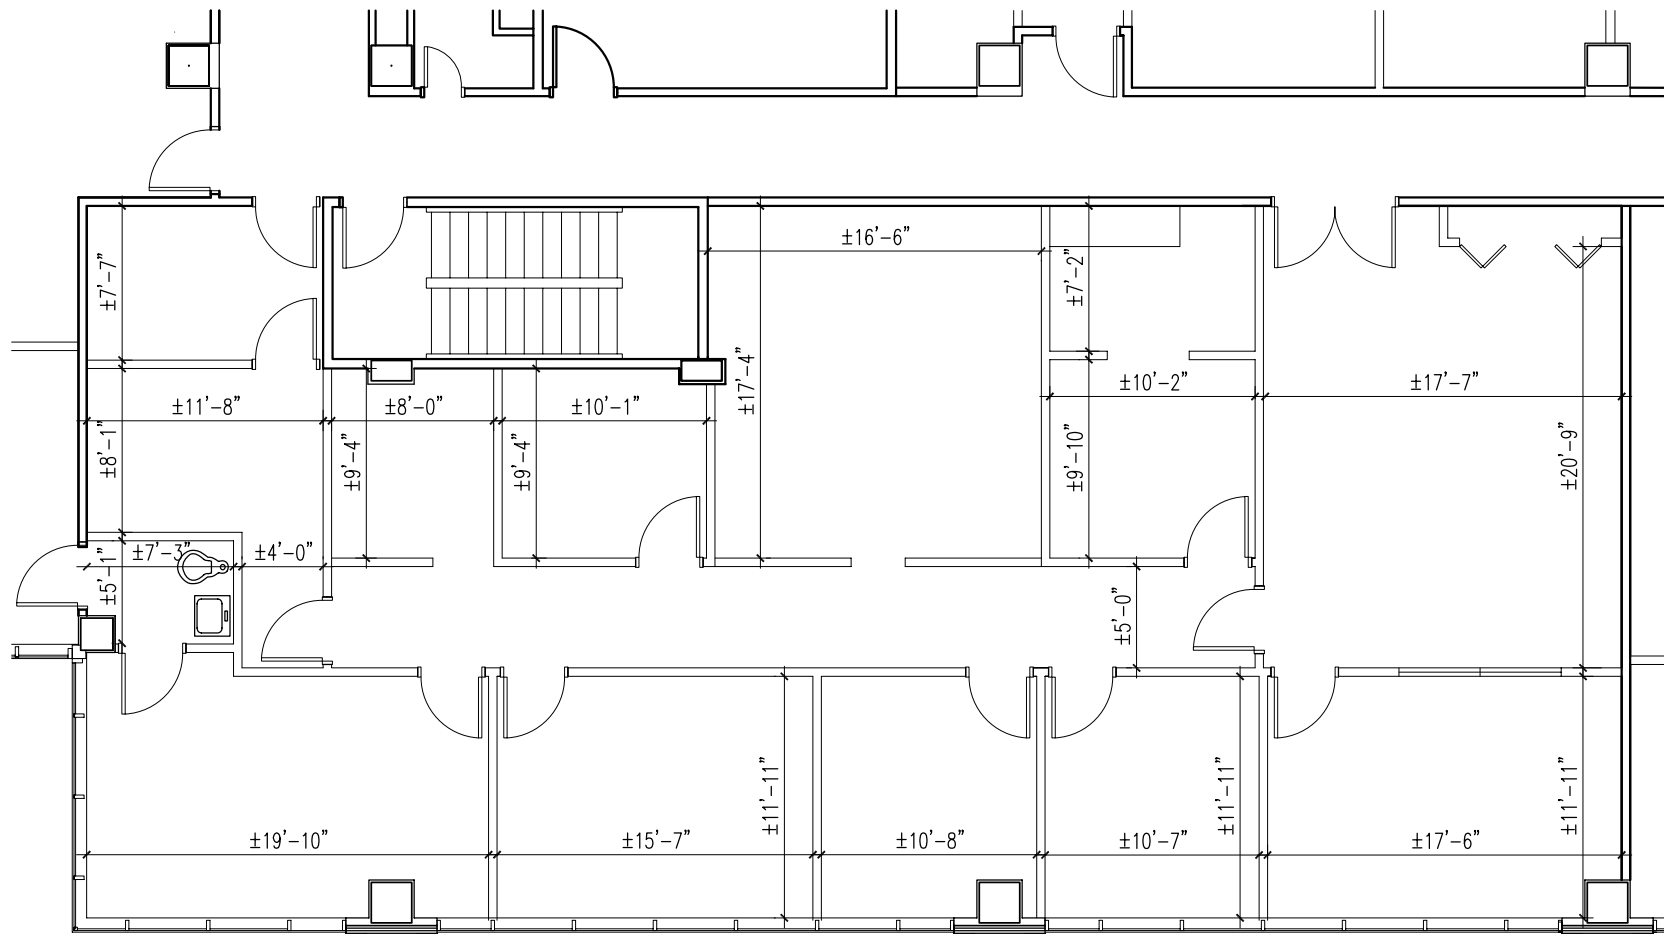

6303 WATERFORD AT BLUE LAGOON

February 6th, 2008

AS-BUILT

SUITE 320
N.T.S.



Leasing by
TAYLOR&MATHIS