



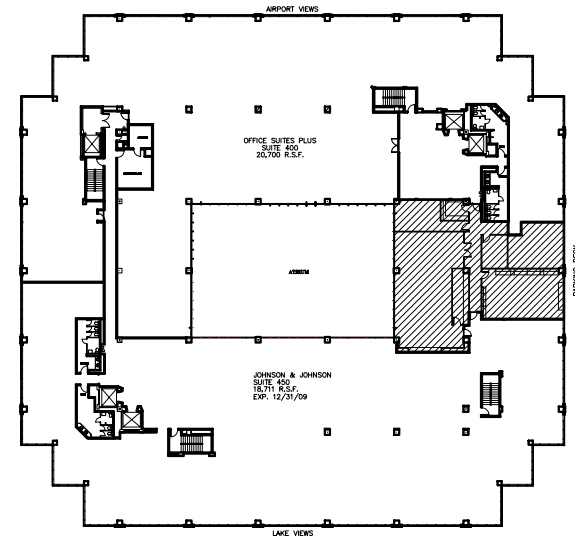

insight
design

1955 Northwest
17th Avenue
Miami
Florida
33125
305 545 4964

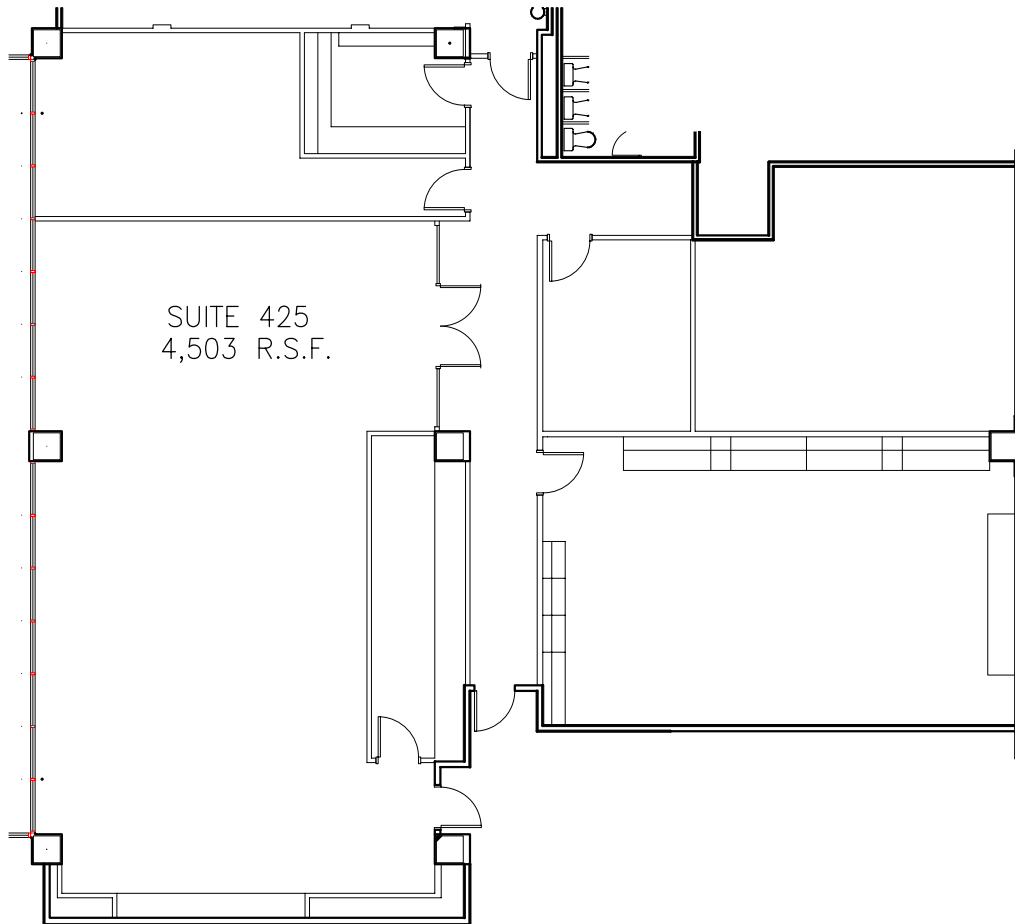

KEY PLAN - 4th FLOOR

6303 Blue Lagoon Dr.

03.18.08

As-Built

Suite 425
N.T.S.