




insight
design

1955 Northwest
17th Avenue
Miami
Florida
33125
305 545 4964

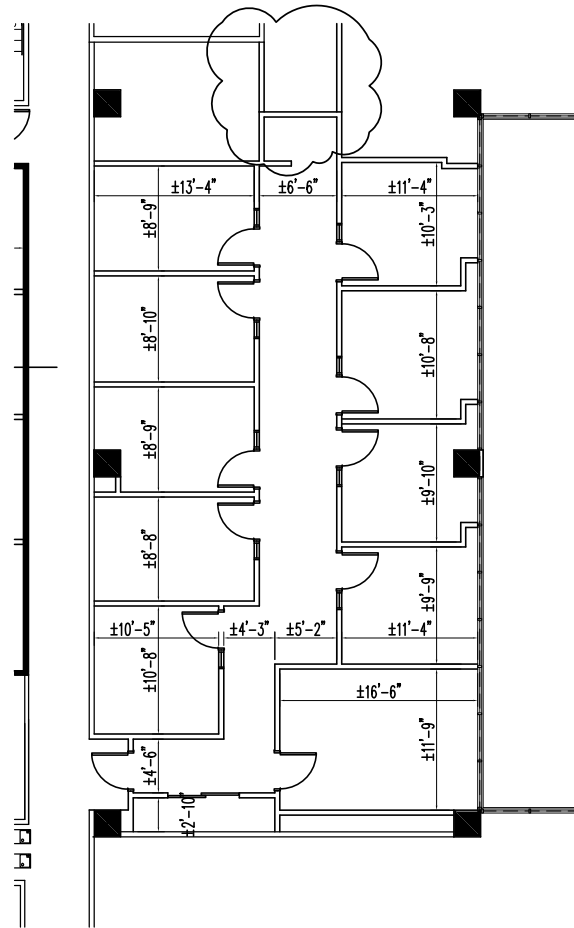

Management & Leasing by
TAYLOR&MATHIS

6505 Blue Lagoon Dr.

October 16th, 2009

AS-BUILT

SUITE 465
N.T.S.

